
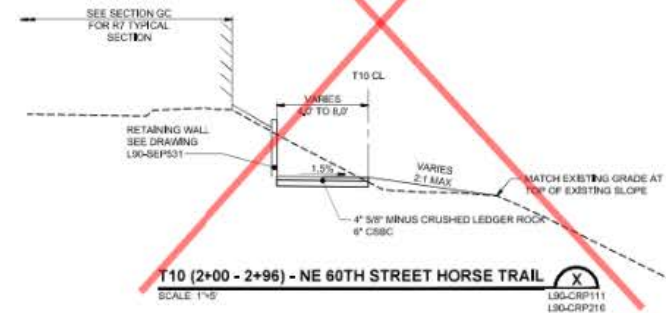


Exhibit E
City of Redmond Trail Lease
ICN 1-17-17753/TR-01-14356
As-Built Cross Section
Page 1 of 1

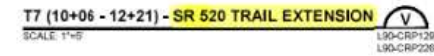

										DESIGNED BY N. LAUGHLIN DRAWN BY P. YAZDKHASTI CHECKED BY J. OLSEN APPROVED BY J. OLSEN																				  										SCALE 1" = 5' PLAN R2004-S0-CRY121 CONTRACT NO. RTA/CN 01-6-18 DATE 09/14/2021										PERMITS HCGS PROJECT INFORMATION DOWNTOWN REDMOND LINK EXTENSION CONTRACT R200 REDMOND TECH STATION TO DOWNTOWN REDMOND CIVIL - ROADWAY TYPICAL ROADWAY SECTIONS T4, T4B, T5, T6, T7, T8 & T10										DRAWING NO. L90-CRY121 PROJECT ID L90 SHEET NO. REV 313 A									
A 08/27/2021 NL GR LO NUC-000051 O 06/14/2021 NL GR LO ISSUED FOR CONSTRUCTION SS DATE DESD APP SUBMIT																																																																					