
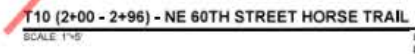
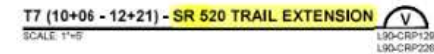
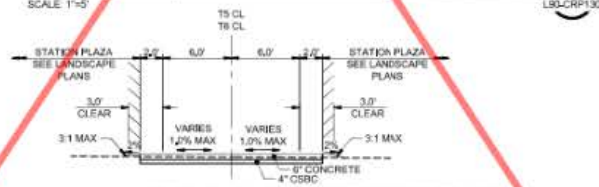
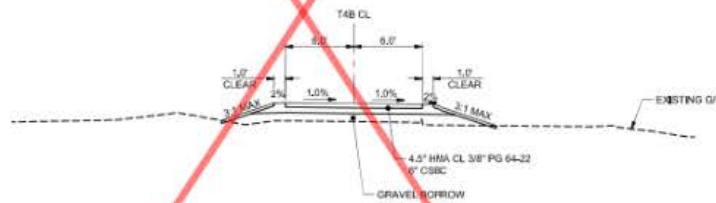


Exhibit E
City of Redmond Trail Lease
ICN 1-17-17753/TR-01-14356
As-Built Cross Section
Page 1 of 1

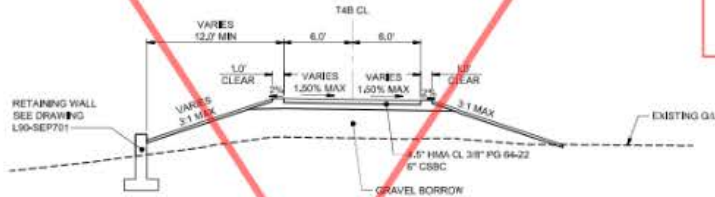

						DESIGNED BY N. LAUGHLIN CHECKED BY P. YAZDGHASTI DRAWN BY J. OLSEN APPROVED BY J. OLSEN		  	SCALE 1" = 5' ELEVATION R200-L90-CRY121 CONTRACT NO. RTA/CN 01-6-18 DATE 09/14/2021	PROJECT PACKAGE HCGS DRAWING INFORMATION	DOWNTOWN REDMOND LINK EXTENSION CONTRACT R200 REDMOND TECH STATION TO DOWNTOWN REDMOND CIVIL - ROADWAY TYPICAL ROADWAY SECTIONS 14, 74D, 75, 76, 77, 78 & 710	DRAWING NO. L90-CRY121 FACILITY ID L90 SHEET NO. 313 REV A
A	08/27/2021	NL	GB	LO	NOC-00001							
0	06/14/2021	NL	GB	LO	ISSUED FOR CONSTRUCTION							
0	DATE	CHK	CHK	APP	STATUS							